
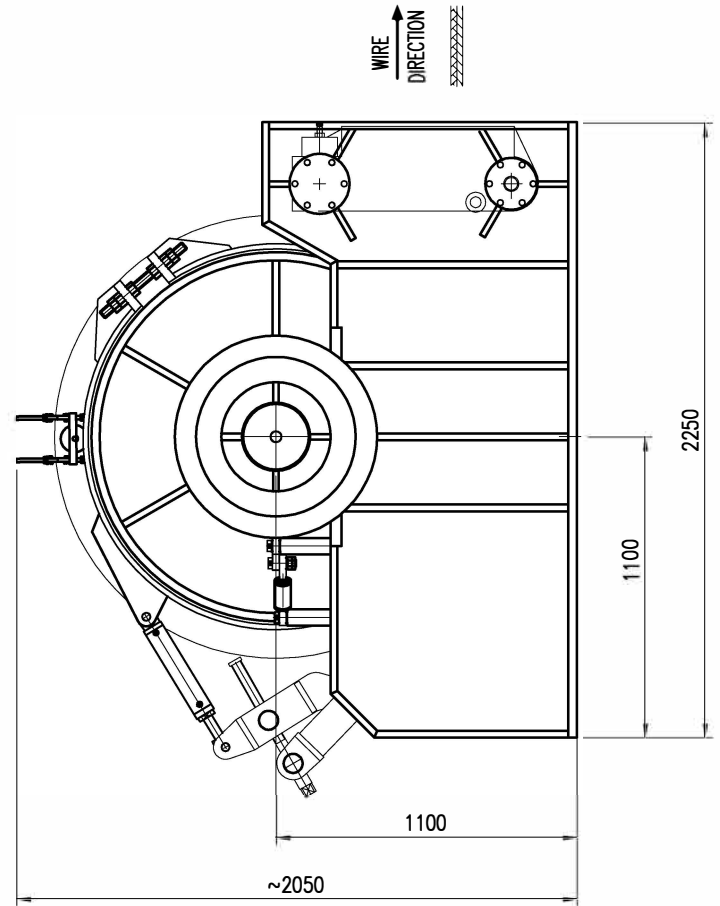


1 2 3 4 5 6 7 8

RevNo	Revision note	Date	Checked	Signature
0	Original	041113		

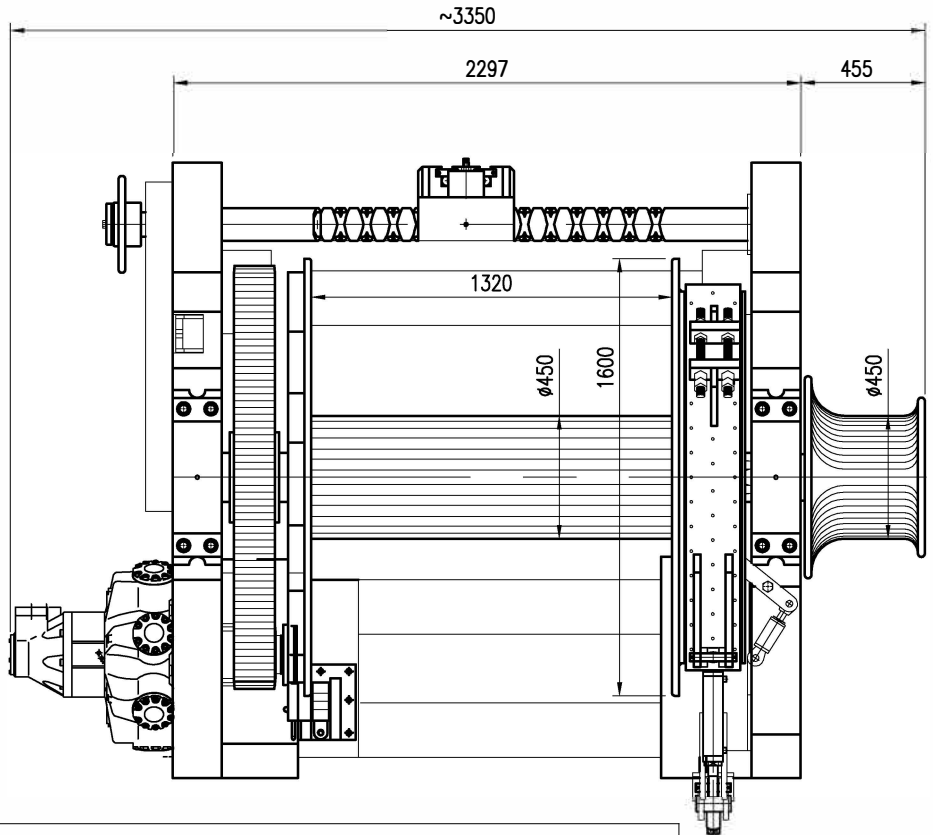

SPECIFICATIONS

Pull/Speed	35Ton @ 1st layer, 10 M/min 18Ton @ 1st layer, 20 M/min
Drum capacity	44mm x 1000 Mtrs
Spooling	Auto spooling device with Manual De-Clutch
Gear	Open Spur Gear & Pinion with Cover.
Brake	Max 90Ton static @1st Layer, hydraulic operated, manual override
Clutch	Claw type, hydraulic operated
Drum stopper	Ratchet type, Manual stopper
Warping end	450
Hyd motor	HMC 270 Staffa

General Tolerances				TR11/10
Fabrication : ± 2				Proj. No.
Machining - Linear : ± 0.25				Dimns in
Angular : ± 30'				MM
Surface Texture C L A : √				
Qty	Client			
Designed	Drawn	Approved	Material	
	SS			
Title: 35 TON HYD WINCH WITH			Drg No:	
AS BUILT GA			TR11/10/35THW/GA/02	
			Scale	A4 Sheet
			NTS	1/1

1 2 3 4 5 6 7 8